

KEY:



2 Gang Removable seats for Wheelchair seating


UP THEATER DILIMAN ALDABA HALL

SEATING PLAN

SCALE: NTS

Drawing Date: September 2022

Print on A4 paper

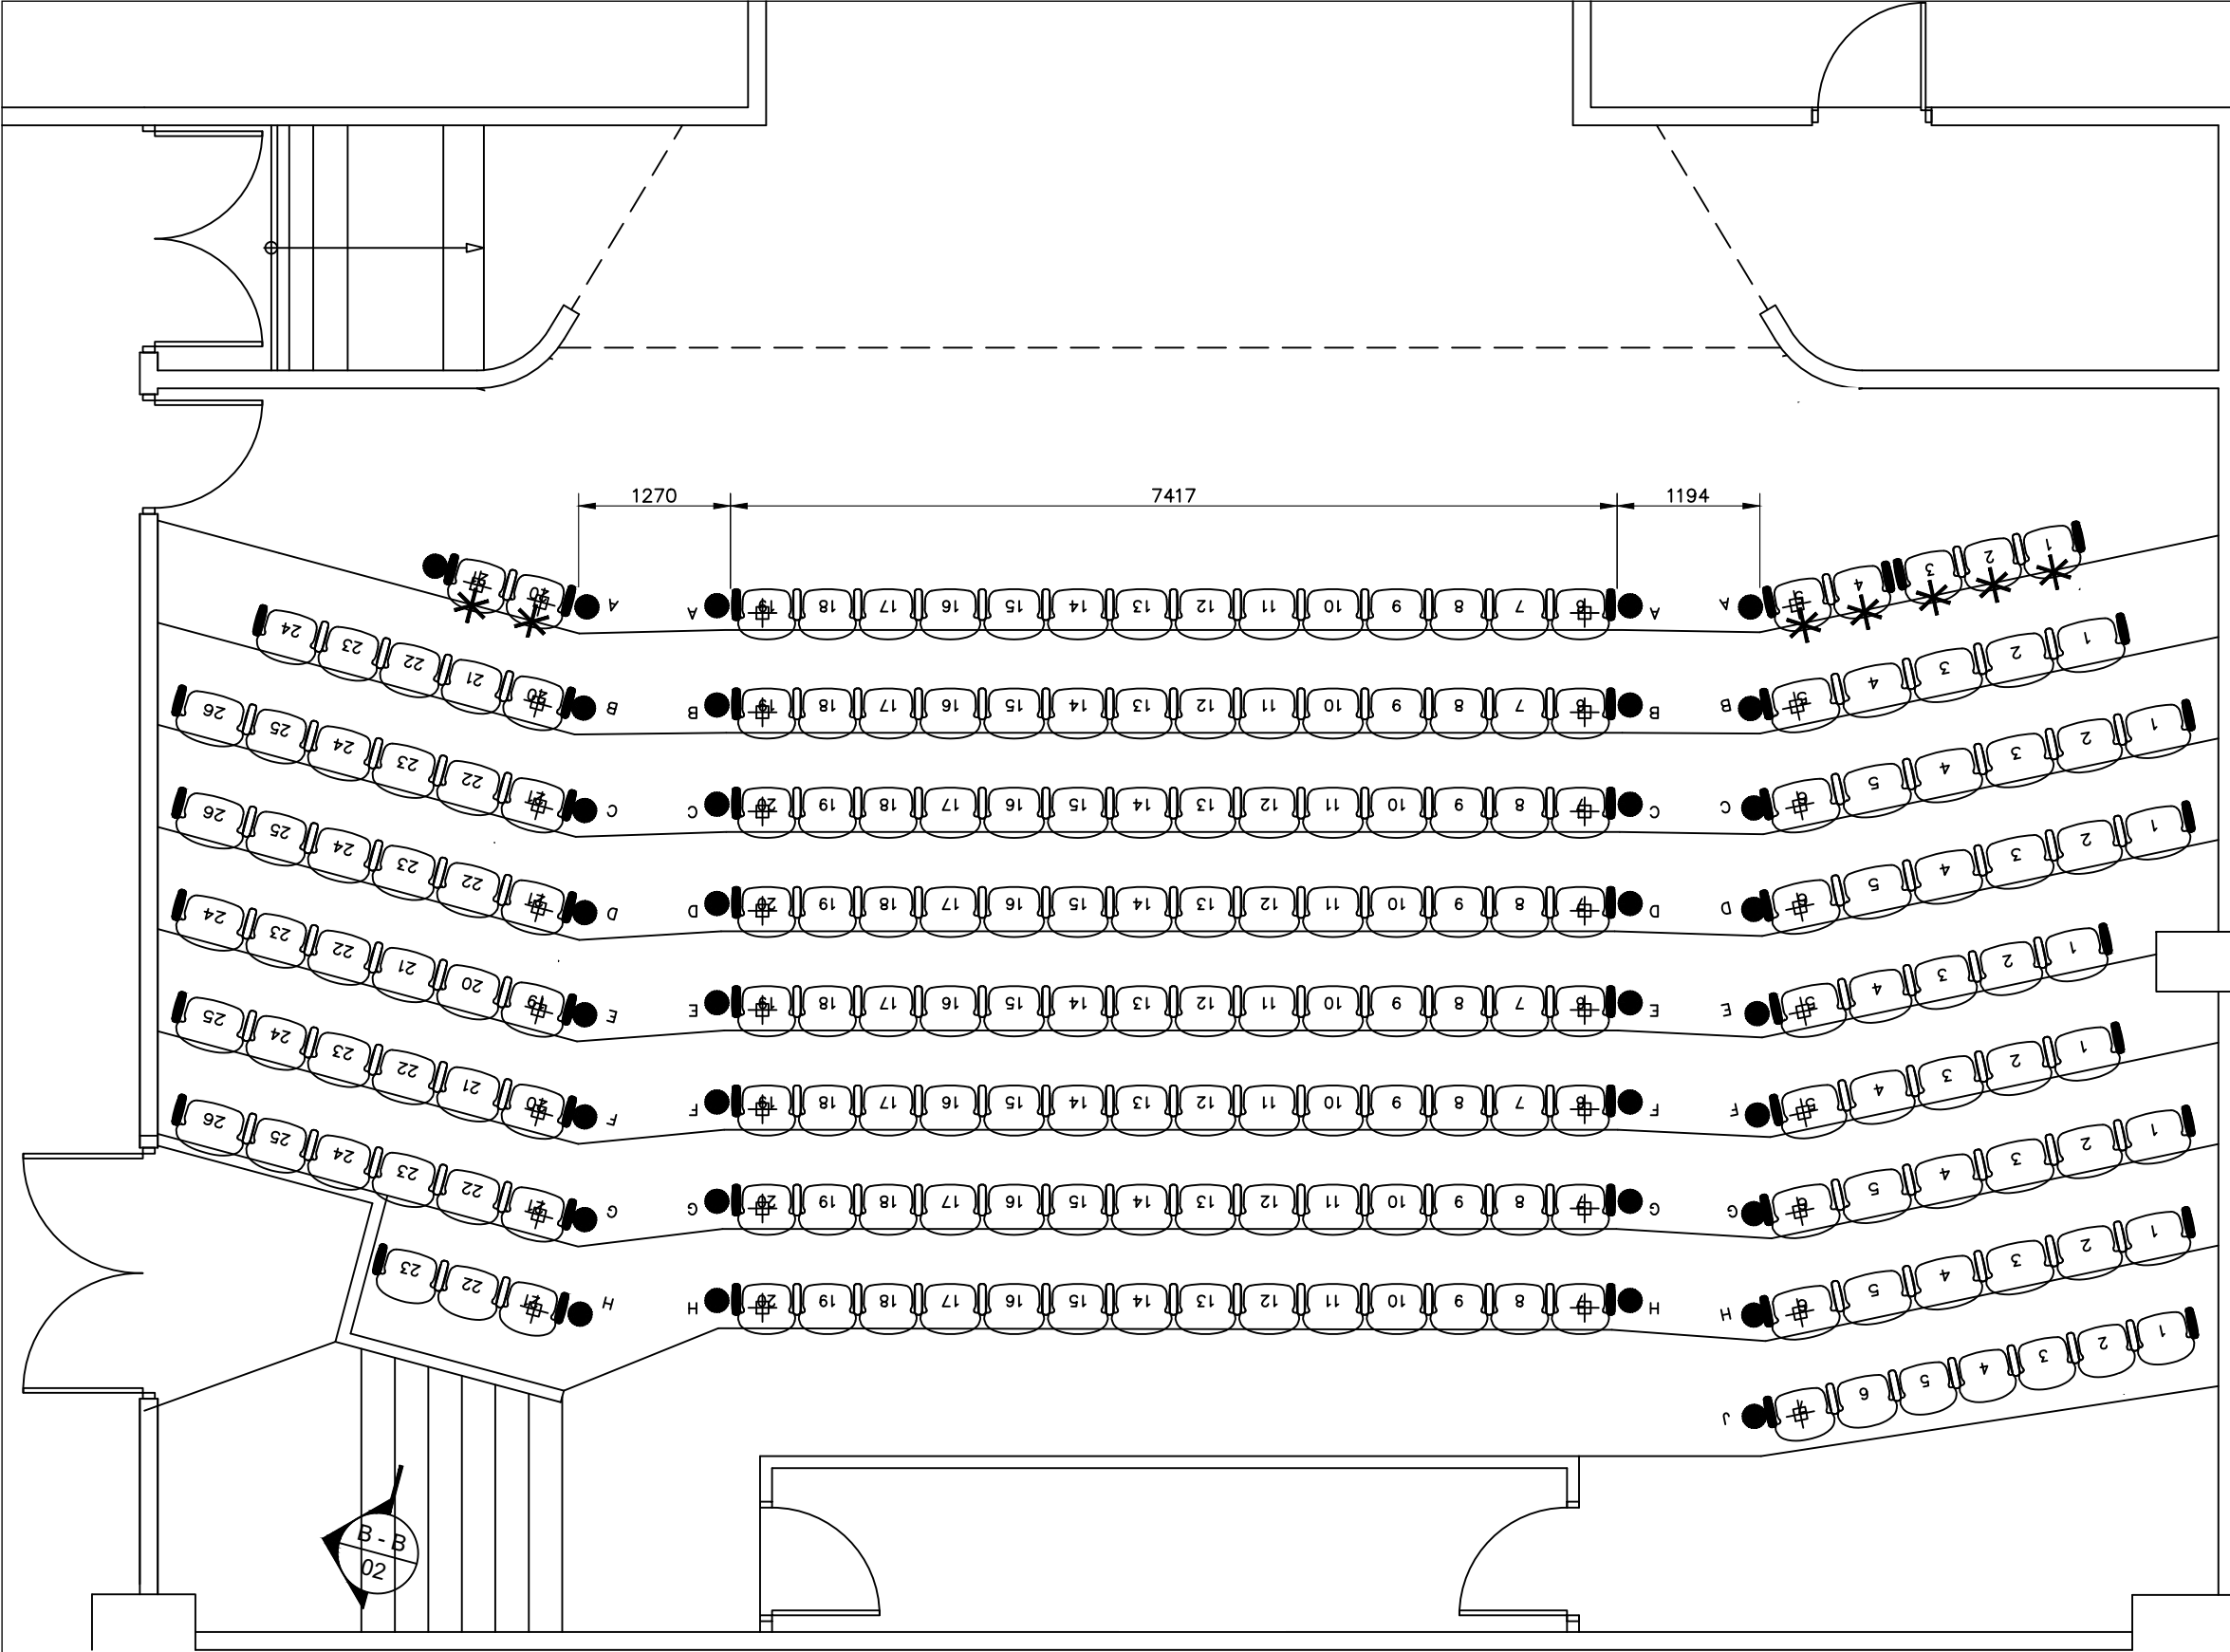

FIXED SEATING SPECIFICATION		
Description		
01	SEAT TYPE:	QUATTRO DESIGNER SERIES.
02	SEAT CENTRES:	508MM, 533MM, 559MM, 584MM, 610MM.
03	SEAT FABRIC:	TAHOE INTERWEAVE BLACK CHERRY TO COMPLY WITH CAL TB 117.
04	SEAT TAILORING:	WATERFALL.
05	SEAT FOAM:	PLUSH.
06	SEAT PAN:	STANDARD, COLOUR TITANIUM.
07	BACK TYPE:	SOFT SQUARE ASH VENEER, COLOUR NATURAL FINISH 7909-60.
08	BACK HEIGHT:	889MM @ 12".
09	BACK FOAM:	51MM CUT FOAM.
10	BACK FABRIC:	TAHOE INTERWEAVE BLACK CHERRY TO COMPLY WITH CAL TB 117.
11	BACK TAILORING:	WATERFALL.
12	ARMREST TYPE:	SOLID ASH, COLOUR NATURAL FINISH 7909-60.
13	END PANEL:	TAPERED, ASH VENEER, COLOUR NATURAL FINISH 7909-60.
14	STANCHION:	TRADITIONAL STEEL FLOOR MOUNTED, #0 FLOOR SLOPE.
15	STANCHION FINISH:	E.P.C. COLOUR TITANIUM.
16	SEAT NUMBERS:	INCLUDED, BRUSHED ALUMINUM.
17	ROW LETTERS:	INCLUDED, BRUSHED ALUMINUM ON END PANEL.
18	AISLE LIGHTS:	INCLUDED, HIGH MOUNT.
19	WRITING TABLET:	NOT REQUIRED.
20	CUPHOLDER:	NOT REQUIRED.
21	POWER & DATA:	NOT REQUIRED.
22	ANCHORS:	ROWS A & K: BY HUSSEY, ROWS B - J: BY OTHERS.
23	STEEL BASES:	6 Nos. INCLUDED, E.P.C. COLOUR TITANIUM.

SPARES :

SEAT ASSEMBLES:

Seat Centre 508mm: 1 No.  
 Seat Centre 533mm: 1 No.  
 Seat Centre 559mm: 1 No.  
 Seat Centre 584mm: 1 No.  
 Seat Centre 610mm: 1 No.

BACK ASSEMBLES:




Seat Centre 508mm: 1 No.  
 Seat Centre 533mm: 1 No.  
 Seat Centre 559mm: 1 No.  
 Seat Centre 584mm: 1 No.  
 Seat Centre 610mm: 1 No.

STANCHIONS:

R/H with end panel and aisle light: 1 No.  
 L/H with end panel and aisle light: 1 No.  
 Intermediate: 2 Nos.  
 ARMREST: 4 Nos.  
 HARDWARE: 3%.

REVISION	DESCRIPTION	DATE
F	UPDATED ARCHITECTURE & CHANGED LAYOUT	09/05/2022
E	CHANGED FLOOR, RISER CONSTRUCTION & ANCHORS.	09/03/2022
D	NO CHANGES THIS SHEET	25/02/2022
C	UPDATED ARCHITECTURE	19/01/2022
B	CHANGED SPECIFICATION	12/11/2021
A	ADDED FINISHES	01/11/2021

**AS-BUILT LAYOUT**

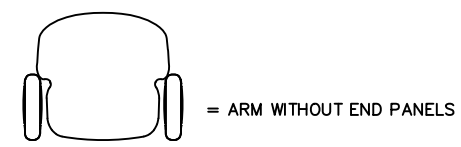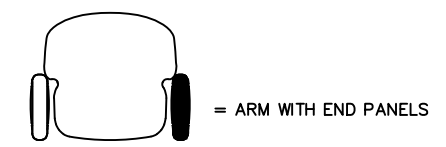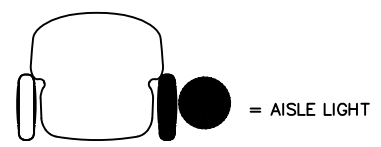

SEATING COUNT

**Fixed Seating**

Seat Type: QUATTRO  
 Seat Centre 508mm: 54 Seats  
 Seat Centre 533mm: 78 Seats  
 Seat Centre 559mm: 24 Seats  
 Seat Centre 584mm: 14 Seats  
 Seat Centre 610mm: 26 Seats  
 Quantity: 196 Seats

**Removable Seating**

Seat Type: QUATTRO  
 Seat Centre 508mm: 13 Seats  
 Quantity: 13 Seats  
 Quantity on 2-Seat Bases: 10 Seats (5 Steel Bases)  
 Quantity on 3-Seat Bases: 3 Seats (1 Steel Base)

**TOTAL SEAT CAPACITY: 209 Seats**

**Hussey** **husseyseating**  
 YOUR PARTNER FOR SEATING SOLUTIONS  
 Hussey Seating Company, North Berwick, Maine 03906  
 www.husseyseating.com info@husseyseating.com

PROJECT  
**UP THEATER COMPLEX - ALDABA HALL**

TITLE  
**SHOP DRAWING**

DRAWN MDT	CHECKED PBP	APPROVED TMP	A3
DRAWING NUMBER AP811118-SD01		REVISION F	SCALE 1/60 DATE 16/09/2021